

### NOTICE TO CONTRACTOR

The existence and location of underground utility pipes or structures shown on these plans are obtained by a search of the available records. To the best of our knowledge there are no existing utilities except as shown on these plans.


The Contractor is required to take due precautionary measures to protect the utility lines shown and any other lines not of record or not shown on these plans.

### ENGINEERS' NOTE

The private engineer signing these plans is responsible for the accuracy and acceptability of the work herein. In the event of discrepancies arising during construction, the private engineer signing these plans shall be responsible for determining an acceptable solution and revising the plans for approval by the City.

### GENERAL NOTES


1. Construction shall be in accordance with the Standard Specifications for Public Works Construction 1976 Edition and the City of Riverside Standard Drawings.
2. It shall be the responsibility of the contractor to clear the Right of Way in accordance with the provisions of law as it affects each utility including irrigation lines and appurtenances and at no cost to the city.
3. Pipe shall be bedded per Case I, Standard Drawing No. 452, unless otherwise specified on the plans.
4. Location of wyes, Laterals and saddles to be determined in the field at the direction of the owner.
5. All stubs and laterals to be constructed in accordance with Standard drawing No. 562. Stubs shall be plugged and capped.
6. Manhole frames and covers to be set as noted in profile by sewer contractor after final paving of streets.
7. Laterals are to be 4" V.C.P. and extended to property line.
8. Prior to construction of the sewer, the contractor is to expose the existing sewer and contact the Engineer for verification of existing location and elevation.
9. Plugs shall be installed and will remain in place where the new sewer connects with the existing sewer until such time as the new sewer is accepted by the city.

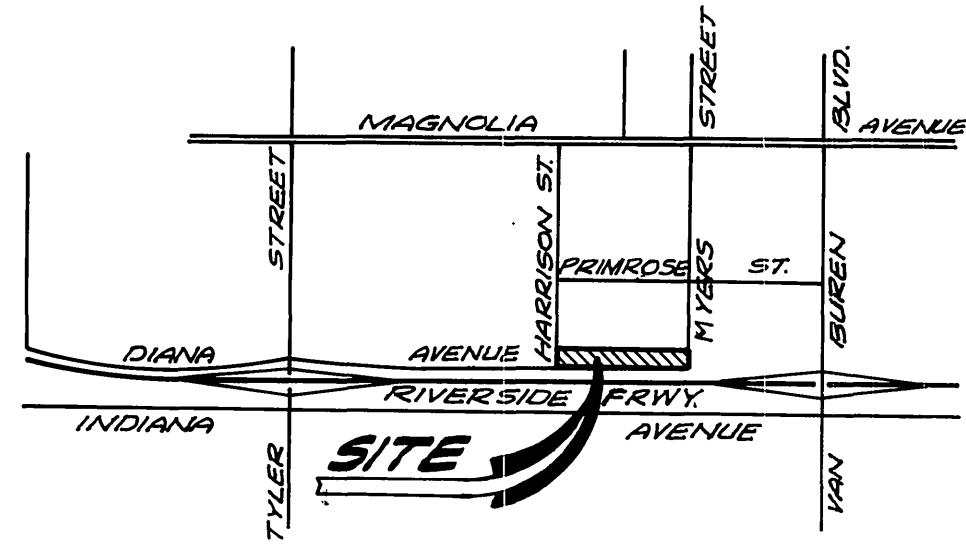

LOCATION MAP  
NO SCALE

### CONSTRUCTION NOTES

- ① Construct 8"x4" saddle.
- ② Join existing chimney.
- ③ Construct 4" V.C.P. lateral to property line.
- ④ Construct 8" V.C.P. sewer line.
- ⑤ Construct Manhole per City Standard No. 500.

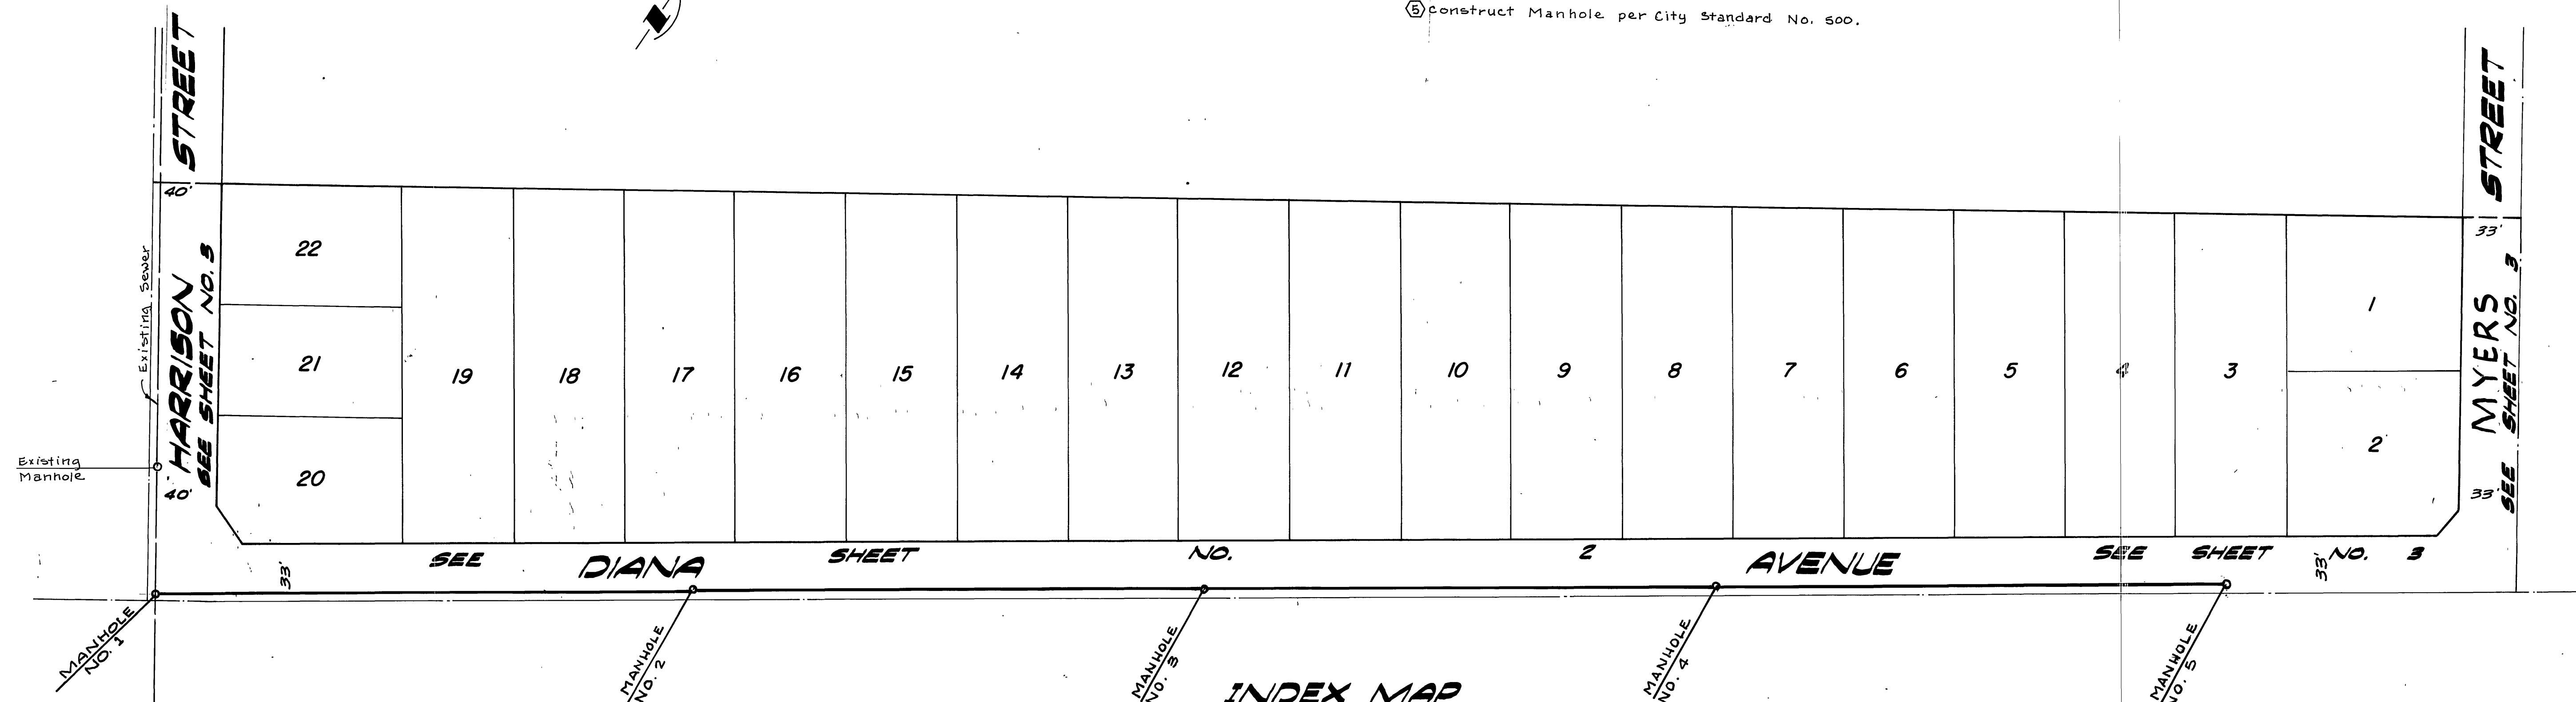

INDEX MAP  
SCALE 1"=50'

### BENCH MARK:


Or-38, at the intersection of Magnolia Avenue & Roosevelt Street, at the Arlington Branch of the Riverside Public Library, on the East side of the Main Entrance, above ground. A Std. disc stamp, c. 1920.  
Elevation 788.349

\*As built 11-86 TE


KICAK WAINSCOTT & ASSOCIATES  
CIVIL ENGINEERS  
GRAND TERRACE, CALIFORNIA  
APPROVED BY L.J. Wainscott DATE 2-3-77  
R.C.E. 1G08G  
Approved by: Wesley Hyden 3-24-77  
Chief Utilities Engineer, Water Date  
W.O. 015-01 FOR OWENS-KENNEDY, INC. F.B.

CITY OF RIVERSIDE, CALIFORNIA  
DEPARTMENT OF PUBLIC WORKS  
APPROVED BY R.W. Johnson BY DATE 10/10/77  
OFFICE ENGINEER PARK DEPARTMENT TRAFFIC DIVISION  
DIRECTOR OF PUBLIC WORKS  
ASSISTANT CITY ENG. 10-6  
DATE 10-5-77  
DESIGNED BY R.H. DRAWN BY P.H. & J.M. CHECKED BY M.W.

SEWER PLAN & PROFILE		PROJECT NO.
TRACT NO. 8/21		S-1089
INDEX SHEET		SHEET 1 OF 3
SCALE AS SHOWN		FILE NO. 015-01-6

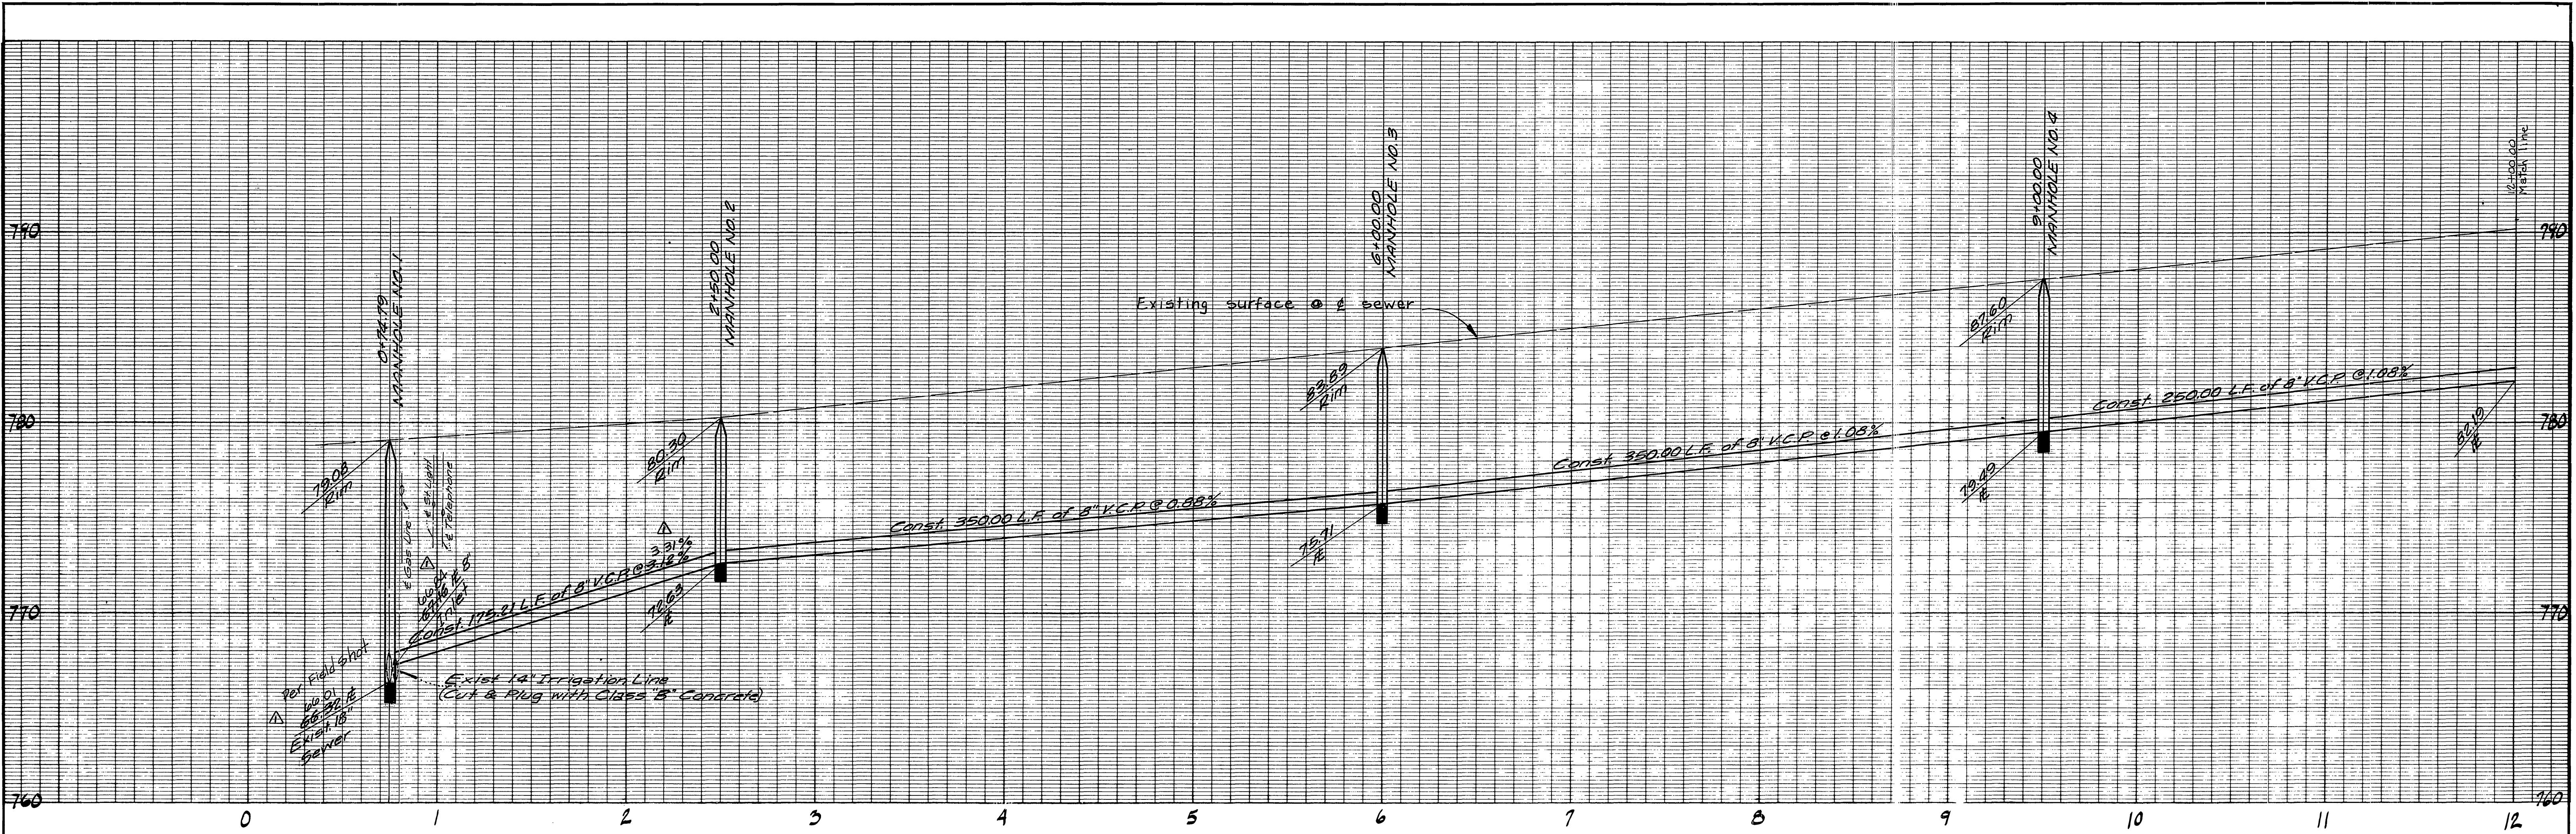

**NOTE:**  
See Sheet No. 1 for General  
and Construction Notes.

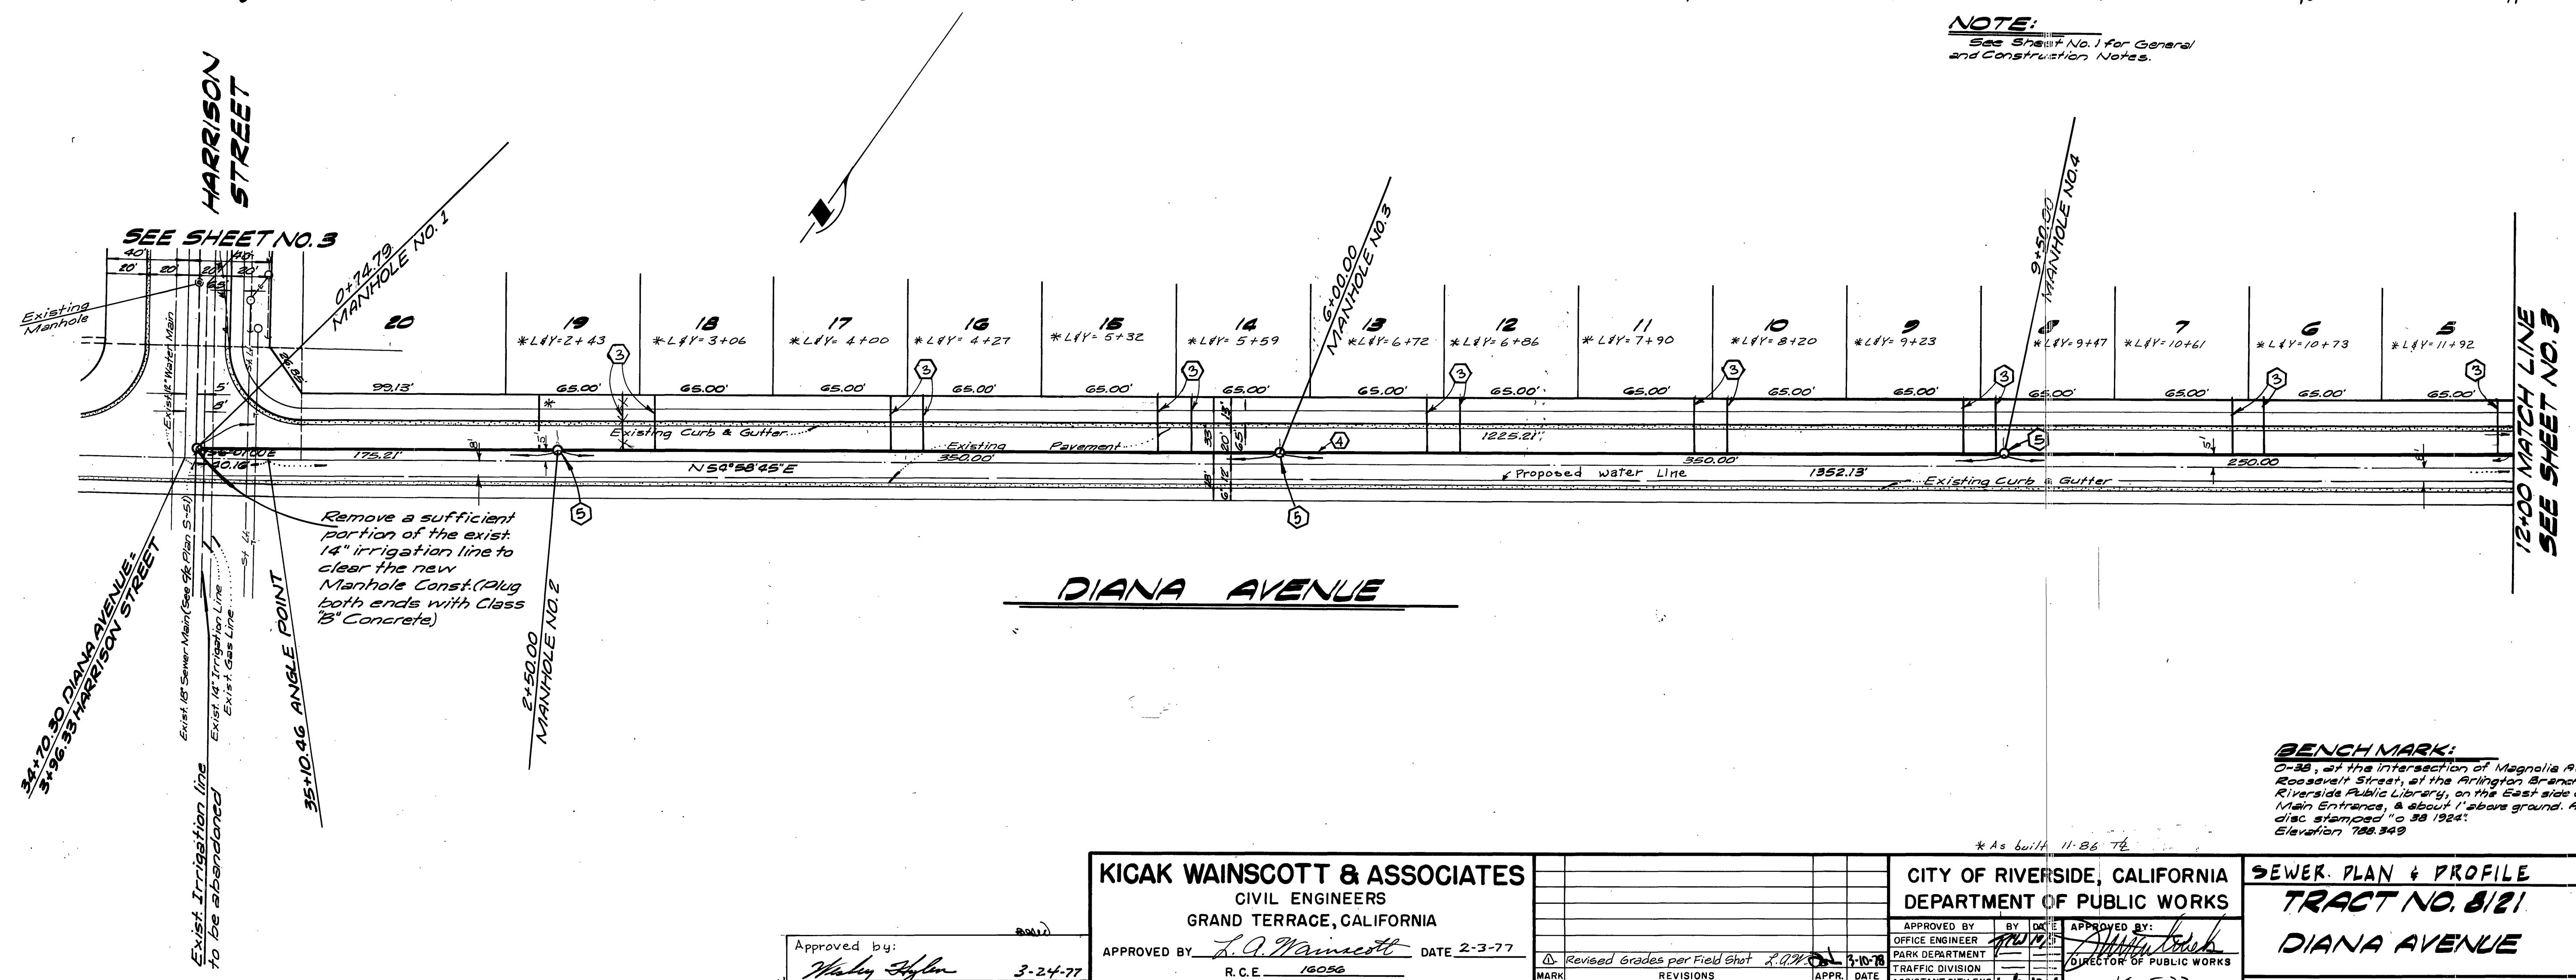

**BENCH MARK:**  
On 38, at the intersection of Magnolia Avenue &  
Roosevelt Street, at the Arlington Branch of the  
Riverside Public Library, on the East side of the  
Main Entrance, & about 1' above ground. A Std.  
disc stamped "O 38 1924".  
Elevation 788.349

INDEXED RR

KICAK WAINSCOTT & ASSOCIATES

CIVIL ENGINEERS  
GRAND TERRACE, CALIFORNIA

APPROVED BY L. J. Wainscott DATE 2-3-77

R.C.E. 16056

W.O. 015-01 FOR OWENS-KENNEDY, INC.

F.B.

CITY OF RIVERSIDE, CALIFORNIA  
DEPARTMENT OF PUBLIC WORKS

APPROVED BY Office Engineer APPROVED BY Director of Public Works

PARK DEPARTMENT M.W. Johnson

TRAFFIC DIVISION J. H. Johnson

ASSISTANT CITY ENG. L. J. Wainscott

DESIGNED BY R.H. DRAWN BY R.H. CHECKED BY R.H.

DATE 10-5-77



SEWER PLAN & PROFILE  
TRACT NO. 8/21

DIANA AVENUE

SHEET 2 OF 3

SCALE: HORIZ. 1"=60'  
VERT. 1"=4'

FILE NO. 015-01-B

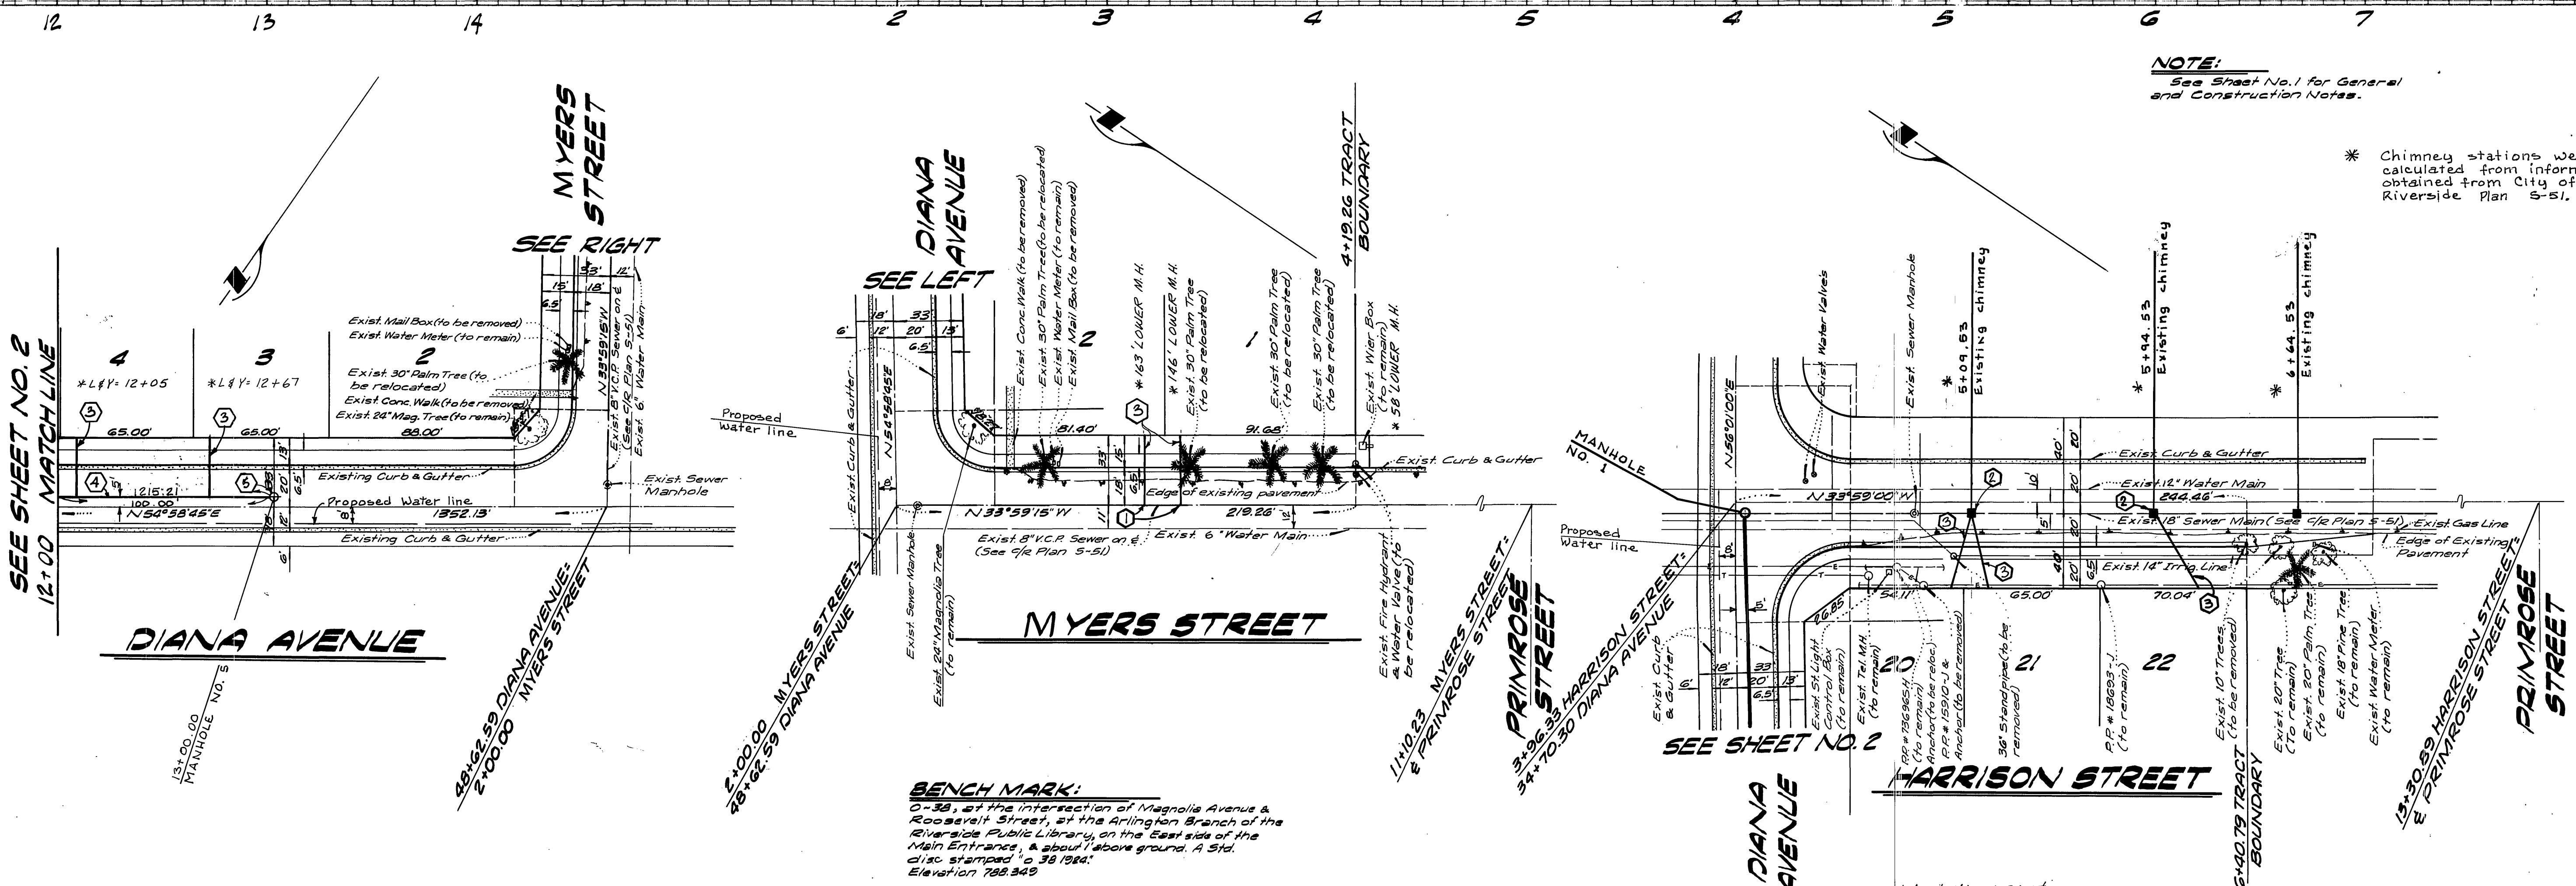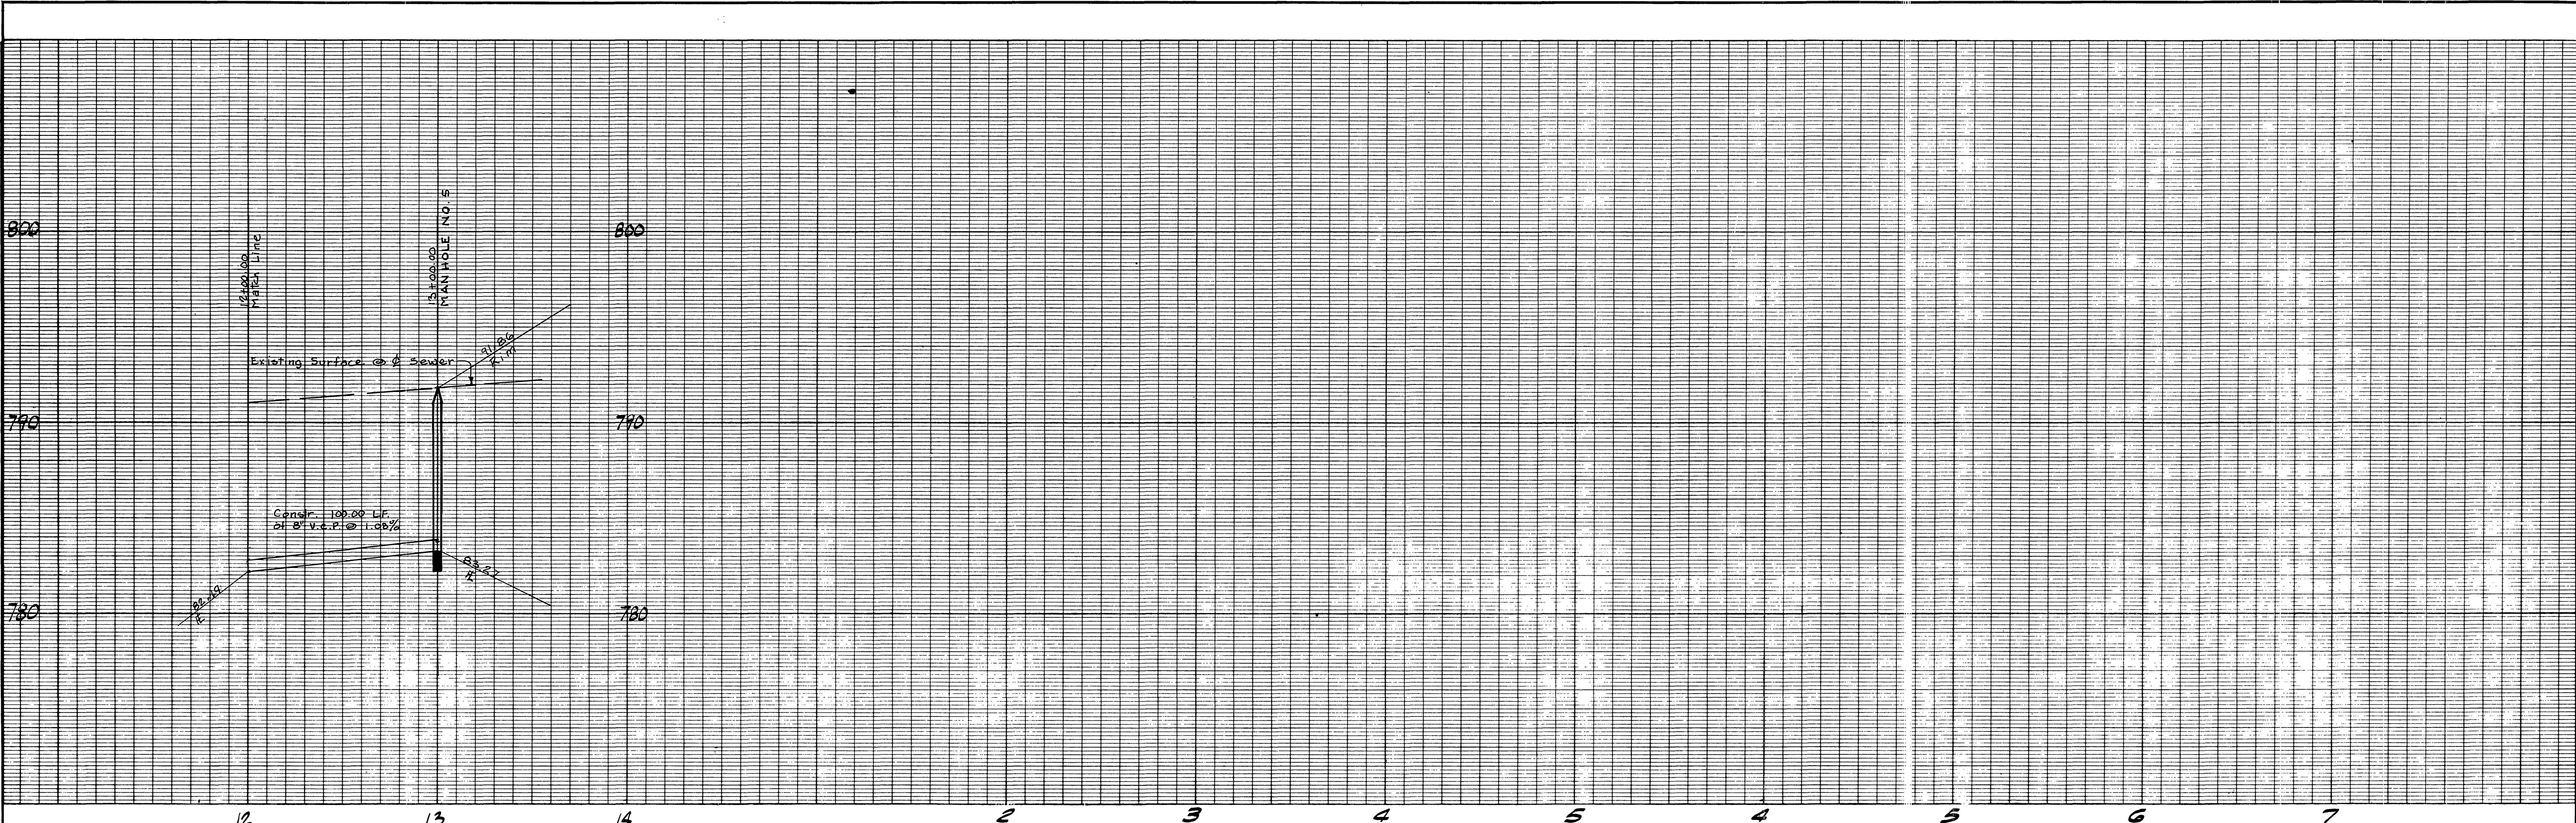

KICAK WAINSCOTT & ASSOCIATES  
CIVIL ENGINEERS  
GRAND TERRACE, CALIFORNIA  
APPROVED BY *L.A. Wainscott* DATE 2-3-77  
R.C.E. 16056  
W.O. 015-01 FOR OWENS-KENNEDY, INC. F.B.  
Approved by: *Wally Yellen* 3-24-77  
Chief Utilities Engineer, Water Dept.

CITY OF RIVERSIDE, CALIFORNIA  
DEPARTMENT OF PUBLIC WORKS  
APPROVED BY *M.W. Hartwick* DATE 10-5-77  
OFFICE ENGINEER *M.W. Hartwick* APPROVED BY *M.W. Hartwick*  
PARK DEPARTMENT *M.W. Hartwick* DIRECTOR OF PUBLIC WORKS *M.W. Hartwick*  
TRAFFIC DIVISION *M.W. Hartwick* ASSISTANT CITY ENG. *M.W. Hartwick*  
MARK REVISIONS APPR. DATE DATE 10-5-77  
DESIGNED BY *R.H.* DRAWN BY *R.H.* CHECKED BY *R.H.*

INDEXED R.R.  
**TRACT NO. 8/21**  
**DIANA AVENUE - MYERS**  
**STREET - HARRISON STREET**  
PROJECT NO. **S-1089**  
SCALE: HORIZ. 1"=40' VERT. 1"=4' FILE NO. 015-01-B  
SHEET **5** OF **3**